

COUNTY

14380801

DATE: 11/25/80 D.S.

TIME: 10:40 A - 11:30 A

JANSON

US EPA RECORDS CENTER REGION 5



498888

Refuse  
removed from  
central low area

Central  
Low  
Area

Kickapoo Creek


1980

STREAM


SECTION 2-2  
LOCATION OF EXISTING AND COMPLETED FILL AREAS

N ← → S

SCALE: HORIZ. 1"=100'  
VERT. 1"=20'

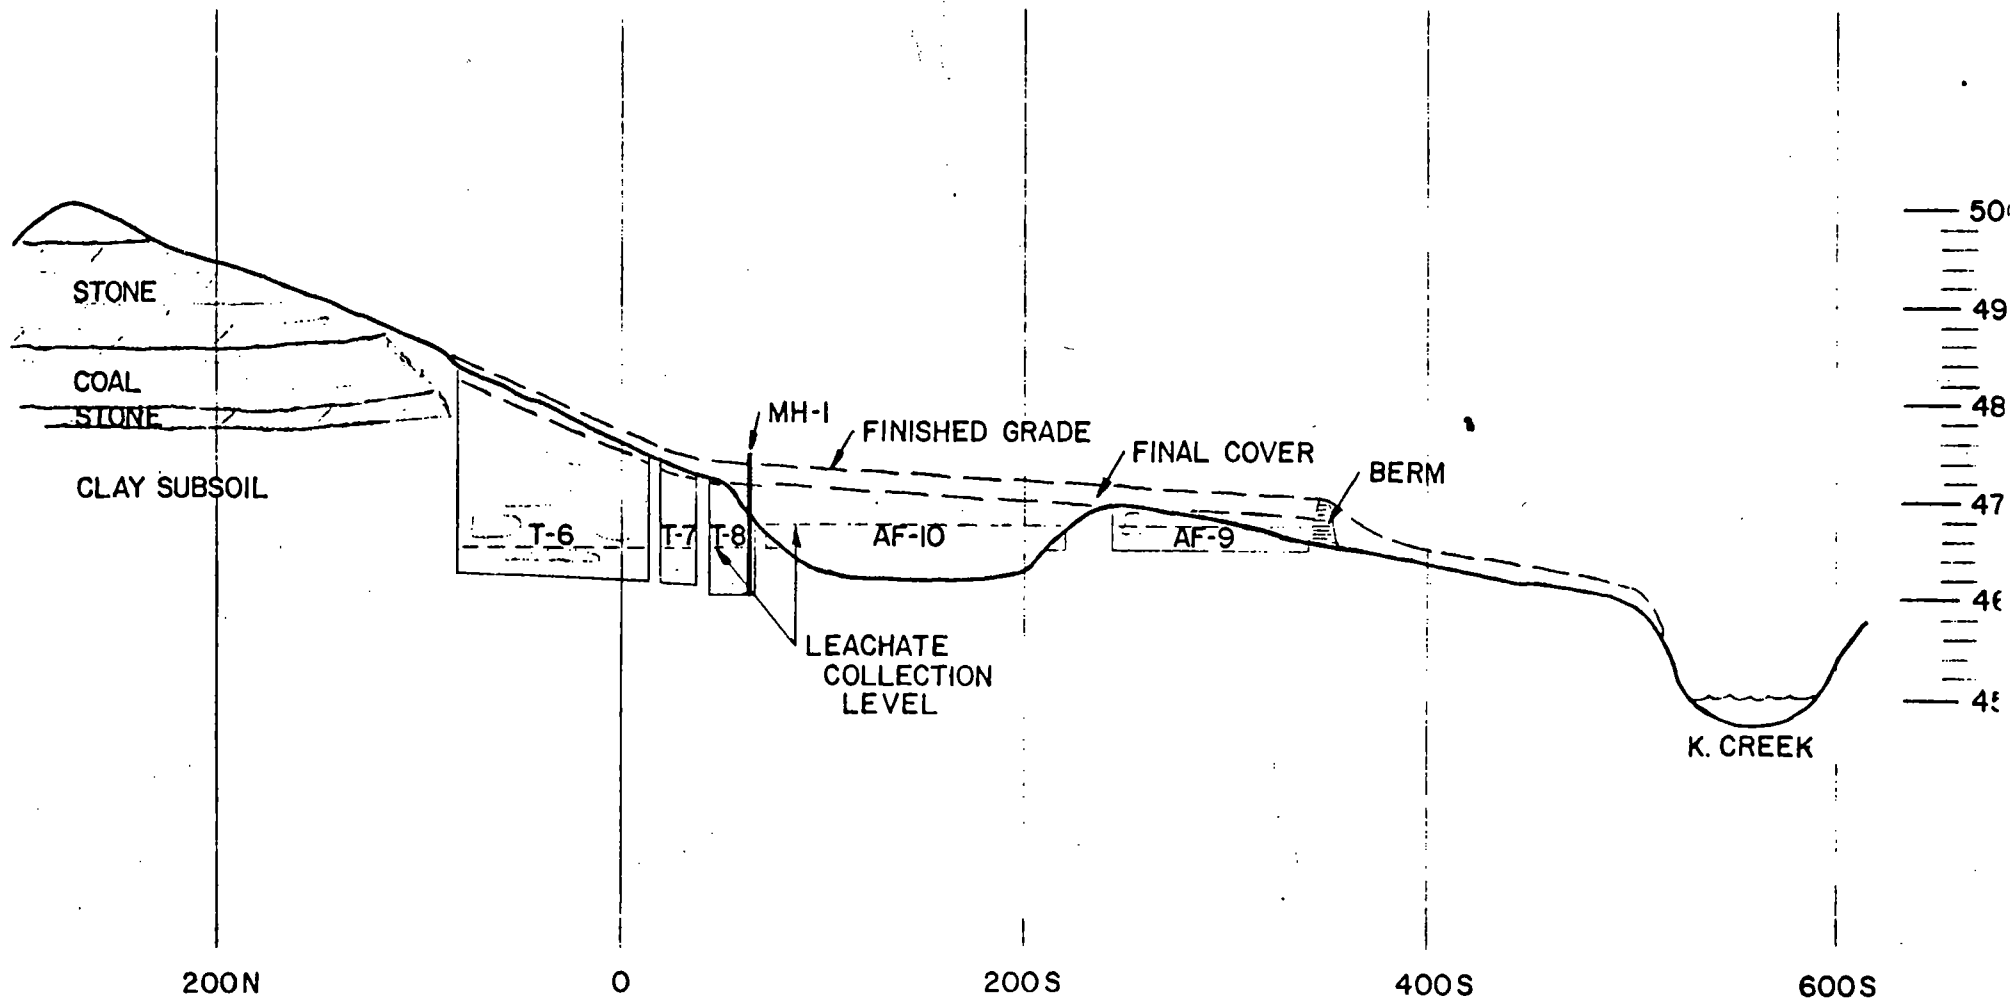


3-14-75

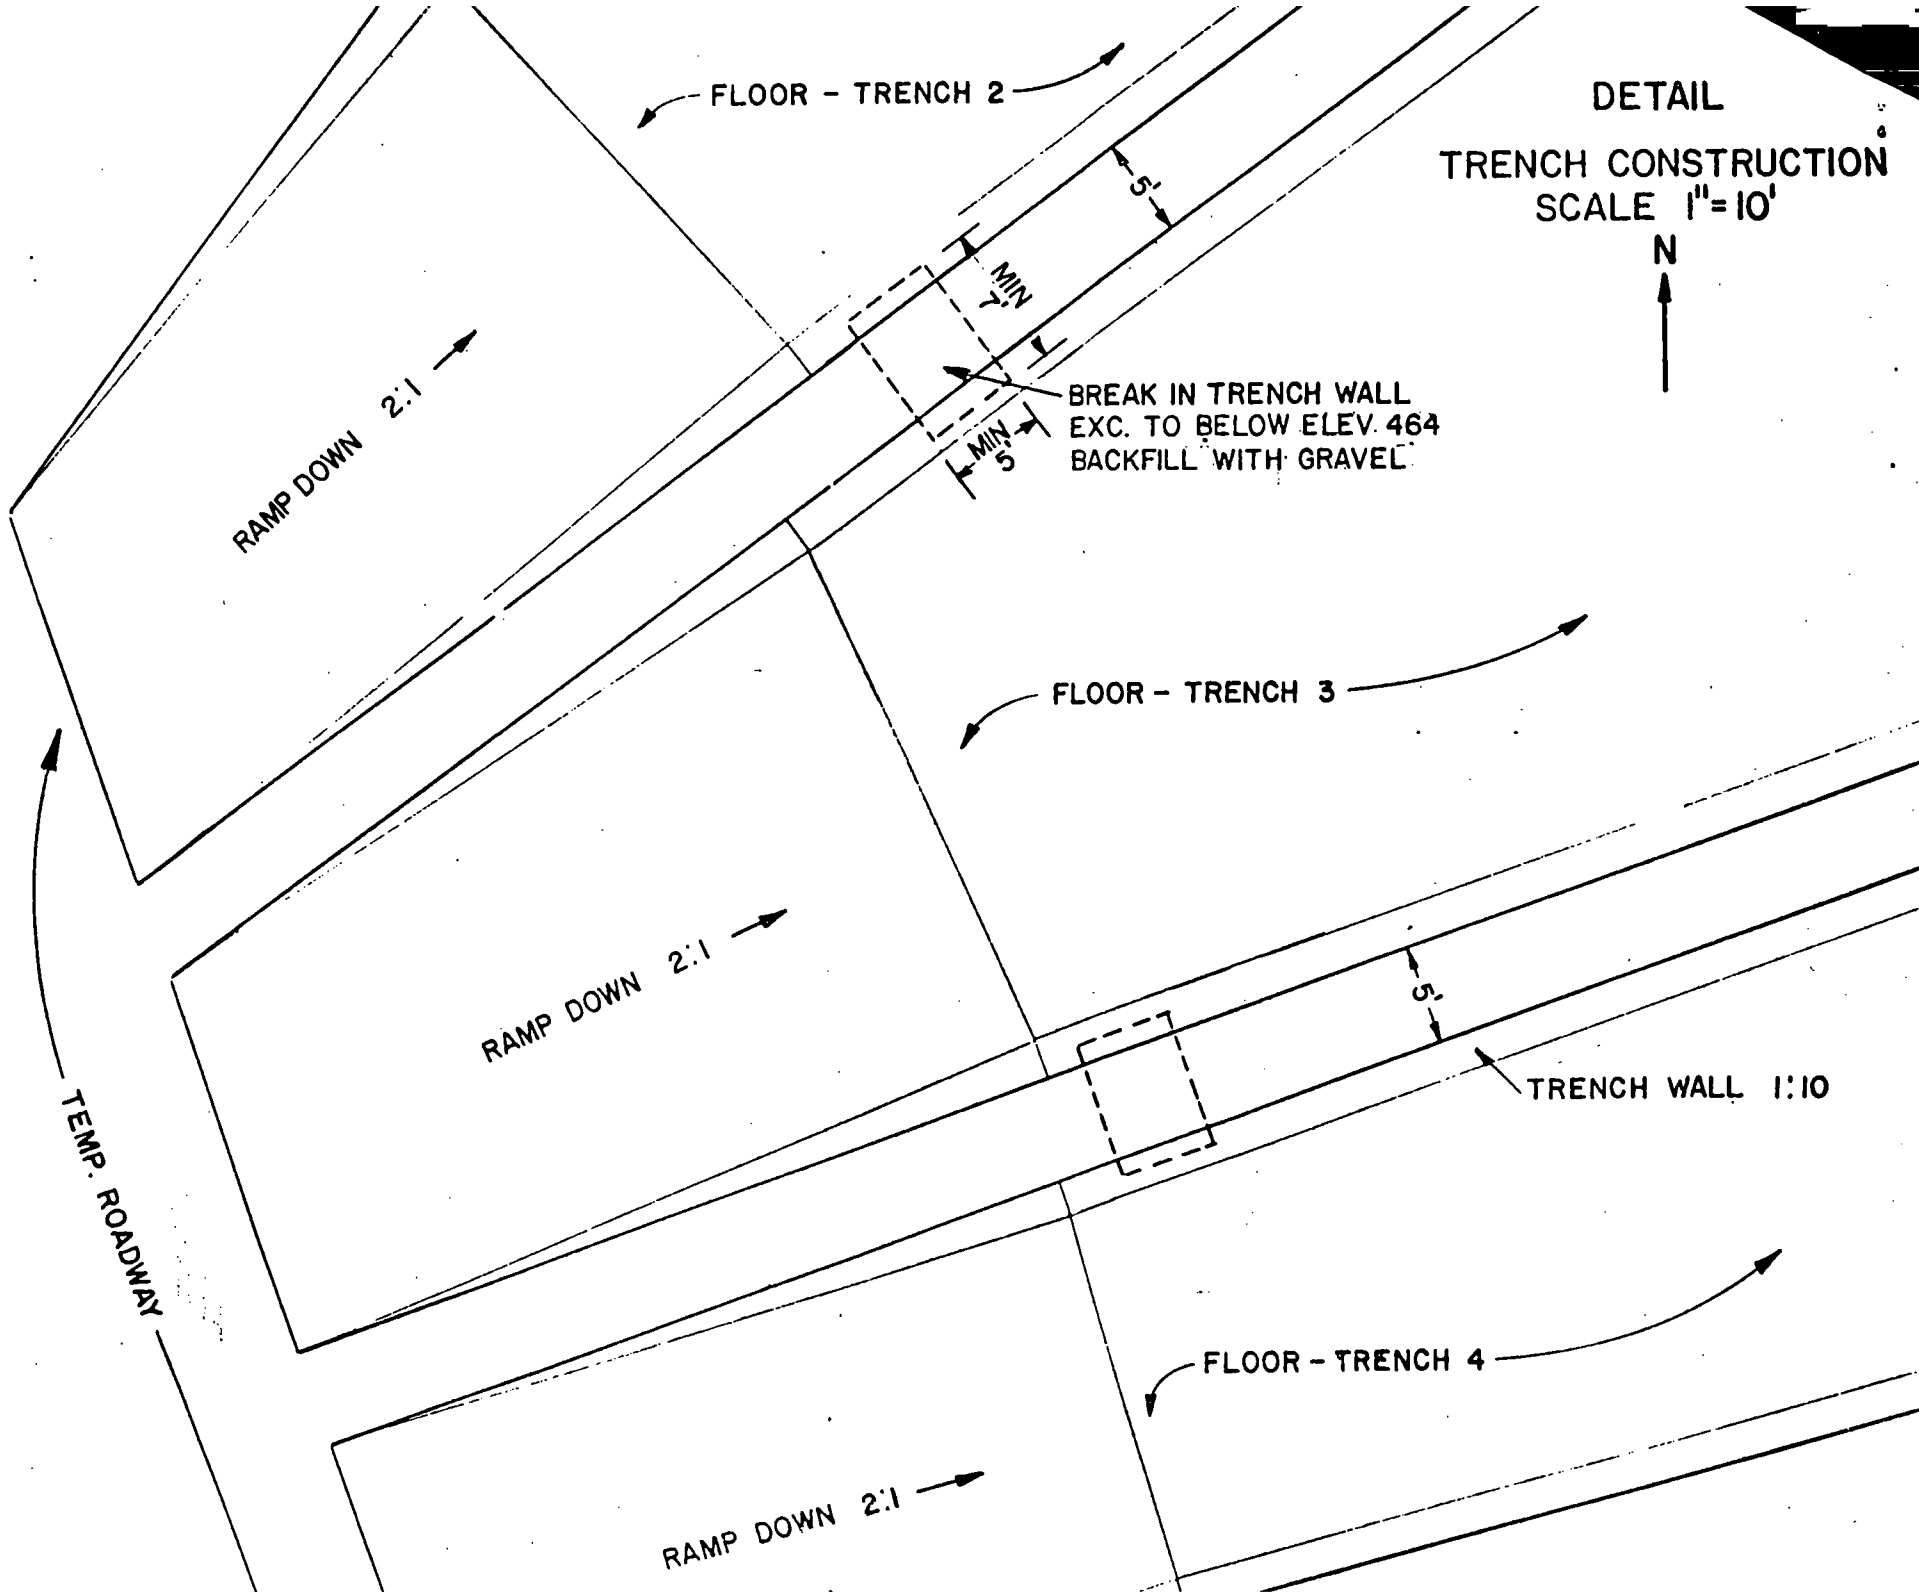

# BERM CONSTRUCTION

FACING WEST  
AT SECTION 2-2

SCALE 1" = 3'

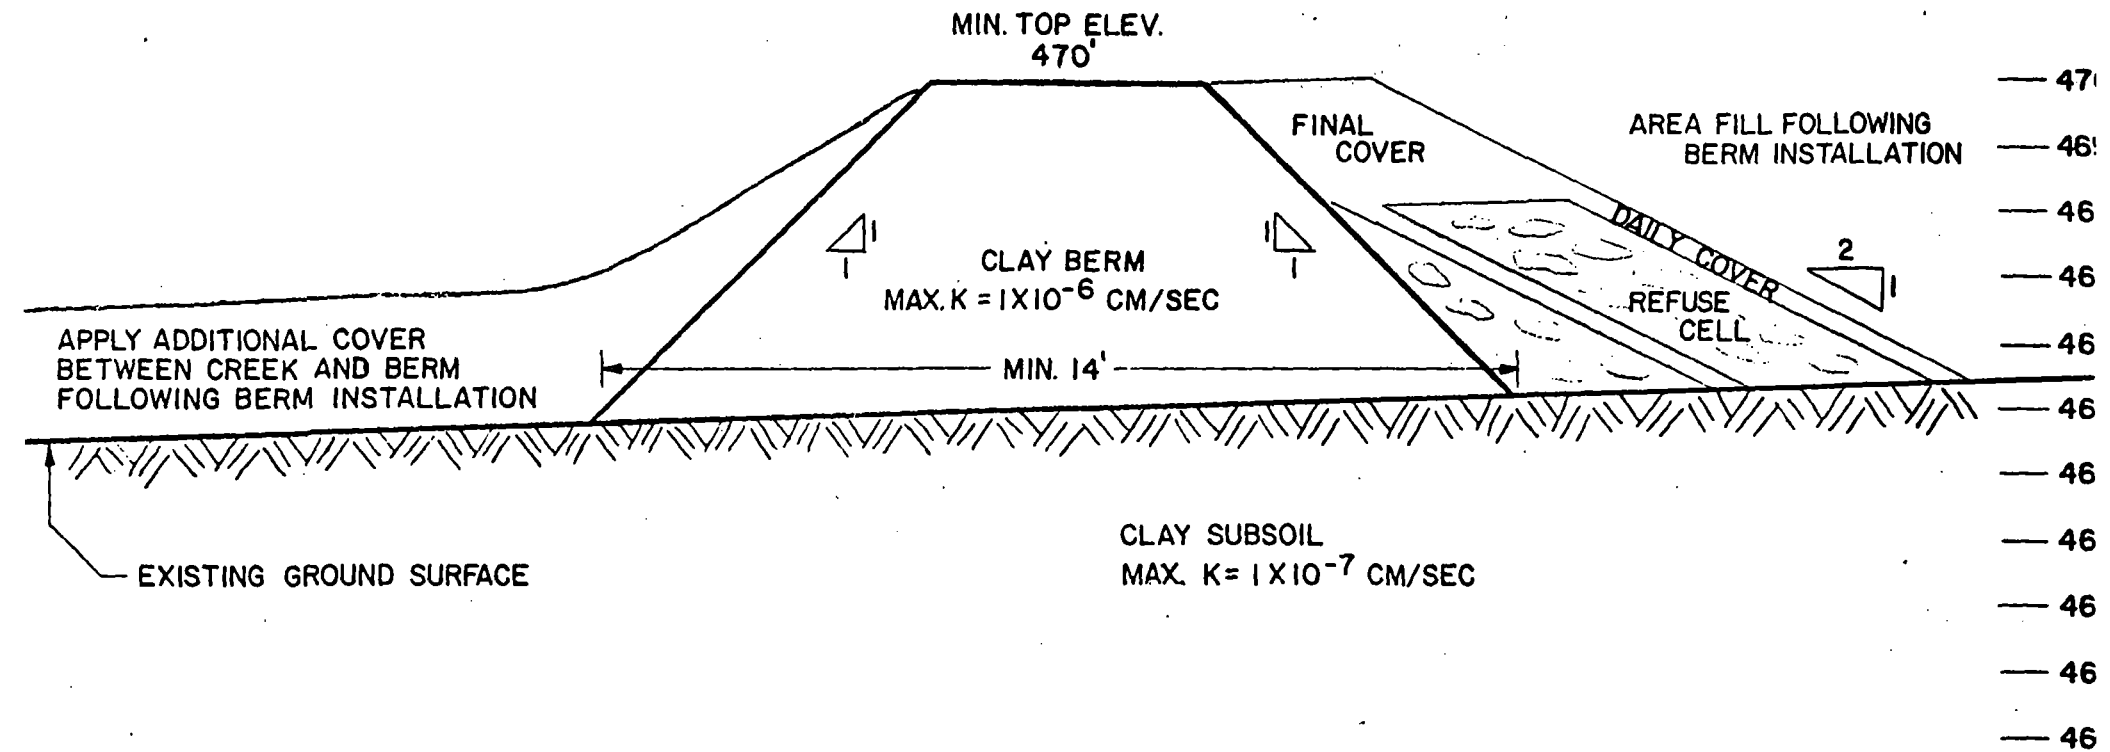

Japan LF

Site @ T8N R7E Sec. 13 NW 1/4

S. 3 mi. R. = T8N R7E

Sec. 13-24-25-36 N 1/2 - 35-26  
23-27-22-21

W. = T8N R7E

Sec. 14-15-16-9-10-11 - 4 SE 1/4 -  
3-2-1-12

---

∴ T8N R7E Sec. 1-2-3-4 SE - 9-10-11-12  
SITE  
13-14-15-16-21-22-23-24-25-26-  
27-35-36 N

---

N. 3 mi. R. = T9N R7E

Sec. 36-35-34 SE


NE T9N R8E Sec. 31 SW

T8N R8E Sec. 5-6-7-8

E T8N R8E Sec. 18-17-16 W - 19-20  
29-30

---

Peara well @ T R Sec  
8-8 7-17 33'-167'

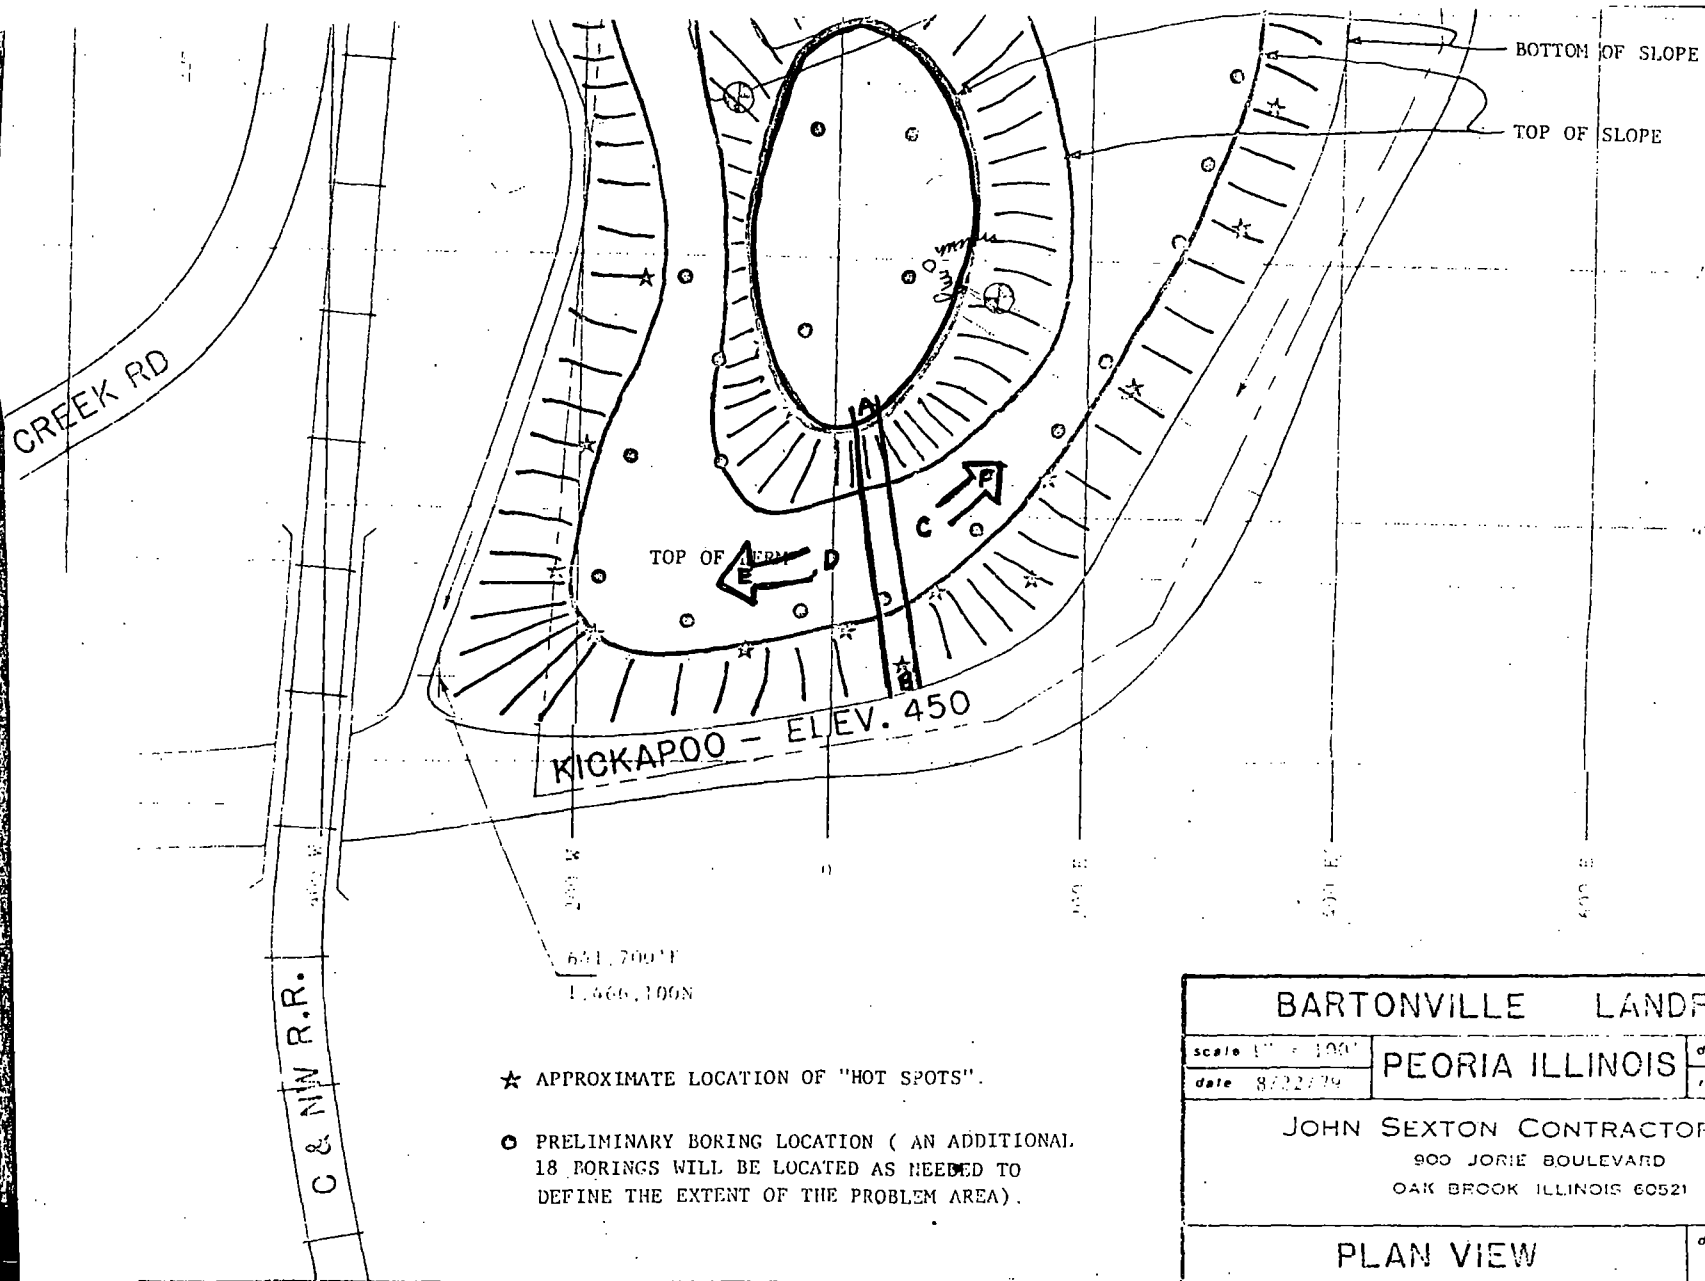

★ APPROXIMATE LOCATION OF "HOT SPOTS".

○ PRELIMINARY BORING LOCATION ( AN ADDITIONAL 18 BORINGS WILL BE LOCATED AS NEEDED TO DEFINE THE EXTENT OF THE PROBLEM AREA).

# BARTONVILLE LANDFILL

scale 1" = 100'

date 8/22/79

PEORIA ILLINOIS

drawn by J.S.

revised 8/24/79


JOHN SEXTON CONTRACTORS CO.

900 JORIE BOULEVARD

OAK BROOK ILLINOIS 60521

PLAN VIEW

drawing number

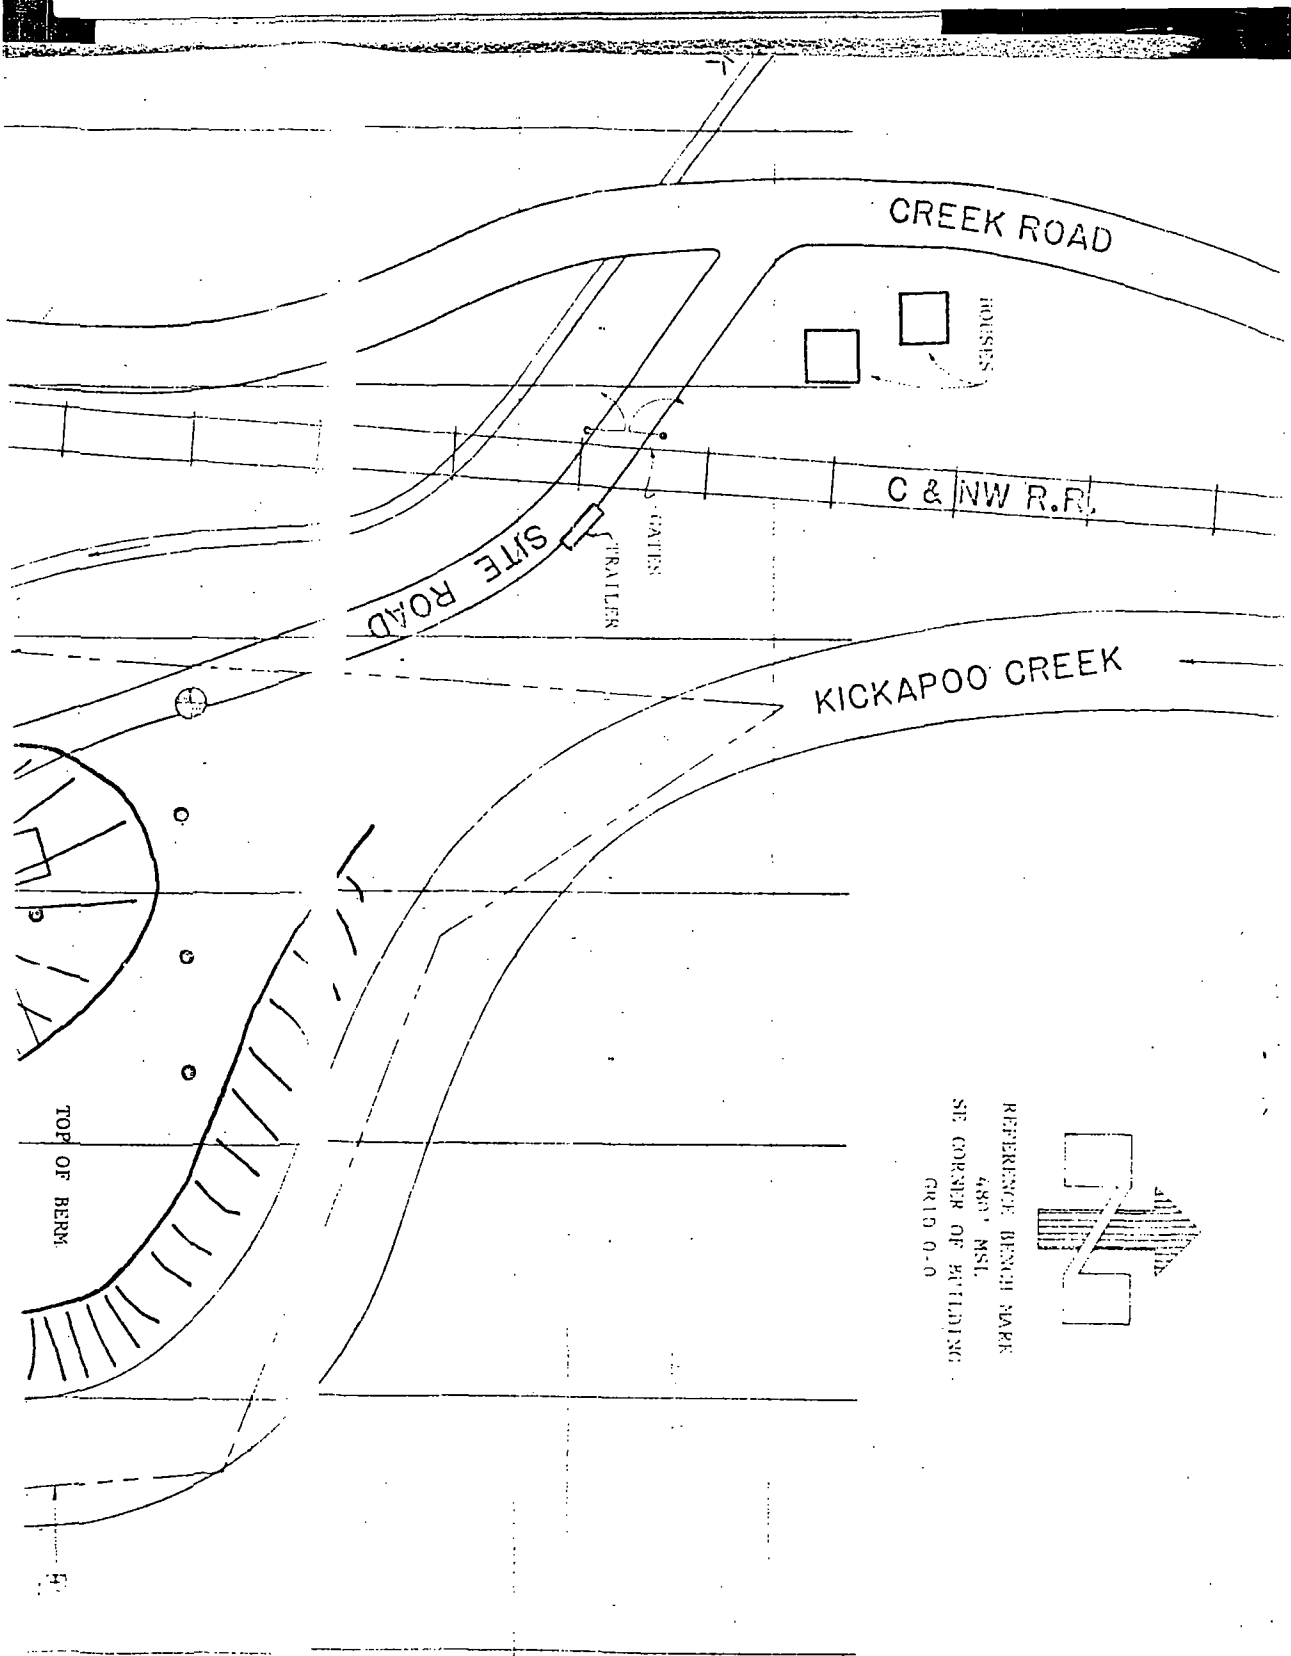

CASE SYNOPSIS

Agency Enforcement File No.: 3942 A Division: Land Pollution Control

Respondent: CHARLES M. JANSON d/b/a BARTONVILLE DISPOSAL

Location of Facility: Section 13, Township 8 N., R. 7 E. of 4th P.M.  
in Peoria County

Nature of Violations Alleged: Violation of PCB# 76-292

Rule 202(b)(1)--Operating w/out Permit

Rule 303(a)-----Depositing improperly

Rule 303(b)-----Compacting

Rule 305(a)-----Daily Cover

Rule 305(b)-----Intermediate Cover

Rule 305(c)-----Final Cover

Rule 314(f)-----Vectors

Controls Available/Approx. Cost:

Rule 311--Open Burning

Rule 313--Tending to cause Water  
Pollution

Close the site

Voluntary Compliance Action Taken:

Suggested Relief/Range of Penalty Sought:  
Court Order

Closure of the site by Circuit

Miscellaneous Relevant Comments:

RECEIVED  
LPC/NPC

MAY 18 1978

ENVIRONMENTAL PROTECTION AGENCY  
STATE OF ILLINOIS

Thomas R. Chivla 5-15-78  
Assigned Attorney Date

[Signature] 5/15/78  
Senior Attorney Date

[Signature]  
Division Manager Date

[Signature] 5/15/78  
Coordinator of Date  
Enforcement Programs



STATE OF ILLINOIS     )  
                                  )  
COUNTY OF SANGAMON    )

PROOF OF SERVICE

I, the undersigned, being duly sworn on oath, depose and state that I have served the attached BOARD ORDER FOLLOW-UP for  
CHARLES M. JANSON d/b/a BARTONVILLE DISPOSAL, IEPA# 3942 A  
upon the person to whom said document(s) is/are directed, by placing a copy in an envelope addressed to:

Mr. George Wm. Wolff, Chief  
Environmental Control Division  
188 West Randolph, Suite 2315  
Chicago, Illinois 60601

and mailing same with sufficient postage affixed, certified mail, return receipt requested; said envelope being deposited in the United States mail, Springfield, Illinois, on May 16, 1978.

Charlene Powell

SUBSCRIBED AND SWORN TO BEFORE ME

this 16th day of May,  
1978.

Anne M. Alexander  
Notary Public

217/782-3397

May 15, 1978

Mr. George Wolff, Chief  
Environmental Control Division  
188 West Randolph, Suite 2315  
Chicago, Illinois 60601

Re: EPA v. Charles Janson  
d/b/a Bartonville Disposal  
PCB 76-292  
IEPA 3942 A

Dear George:

The Pollution Control Board issued an Opinion and Order in the above-captioned case on May 12, 1977. Respondent was found to be in violation of numerous sections of the Act and Solid Waste Rules. Respondent was ordered to "cease and desist all further violations of the Board's Regulations and the Act." This letter is prompted by Respondent's failure to cease and desist violations.

Specifically, Respondent is in violation of the Board Order by:

A. Causing or allowing the use or operation of a solid waste management site without an Operating Permit issued by the Agency, in violation of Rule 202(b)(1) and Section 21(a) of the Act. This allegation is substantiated by the following evidence:

1. August 12, 1977
  - a. Inspection report by John Taylor noting continuing operations (see page 1).
2. September 2, 1977
  - a. Inspection report by John Taylor noting continuing operations (see page 3).
3. September 8, 1977
  - a. Inspection report by Tom Scotese noting continuing operations (see page 6).
4. September 29, 1977
  - a. Inspection report by John Taylor noting continuing operations (see page 11).
5. October 6, 1977
  - a. Inspection report by John Taylor noting continuing operations (see page 15).

6. March 8, 1978
  - a. Inspection report by Tom Scotese noting continuing operations (see page 18).
7. March 9, 1978
  - a. Inspection report by Terry Ayers noting continuing operations (see page 25).
8. March 10, 1978
  - a. Inspection report by Terry Ayers noting continuing operations (see page 36).
  - b. Inspection memo by Tom Scotese noting continuing operations (see page 38).
  - c. Two (2) photographs taken by Tom Scotese showing dumping at site (see pages 23-24).

B. Failure to deposit all refuse into the toe of the fill or into the bottom of the trench, in violation of Rule 303(a) on the following dates:

1. March 9, 1978
  - a. Inspection report by Terry Ayers (see page 25).
2. March 10, 1978
  - a. Inspection report by Terry Ayers (see page 36).

C. Failing to spread and compact all refuse as rapidly as it is deposited at the toe of the fill, in violation of Rule 303(b) on the following dates:

1. September 29, 1977
  - a. Inspection report by John Taylor (see page 11).
2. March 9, 1978
  - a. Inspection report by Terry Ayers (see page 25).
3. March 10, 1978
  - a. Inspection report by Terry Ayers (see page 36).

D. Failing to place a compacted layer of at least 6 inches of suitable cover on all exposed refuse at the end of each day of operation, in violation of Rule 305(a) and Section 21(a) and (b) of the Act on the following dates:

1. August 12, 1977
  - a. See inspection report, page 1.
  - b. Two (2) photographs, page 2.
2. September 2, 1977
  - a. See inspection report, page 3.
  - b. Three (3) photographs, pages 4-5.

3. September 8, 1977
  - a. See inspection report, page 6.
  - b. Five (5) photographs, pages 8-10
4. September 29, 1977
  - a. See inspection report, page 11.
  - b. Four (4) photographs, pages 13-14.
5. October 6, 1977
  - a. See inspection report, page 15.
  - b. Three (3) photographs, pages 16-17.
6. March 8, 1978
  - a. See inspection report, page 18.
  - b. Four (4) photographs, pages 19-22.
7. March 9, 1978
  - a. See inspection report, page 25.
  - b. Eight (8) photographs, pages 26-33.
8. March 10, 1978
  - a. See inspection report, page 36.
  - b. See inspection memos, pages 37-38.
  - c. Thirteen (13) photographs, pages 20-22, 26-34.

E. Failing to place a compacted layer of at least 12 inches of suitable material on all surfaces of the landfill where no additional refuse will be deposited within 60 days, in violation of Rule 305(b) and Section 21(a) and (b) of the Act on the following dates:

1. March 9, 1978
  - a. See inspection report, page 25.
2. March 10, 1978
  - a. See inspection report, page 36.

F. Failing to place a compacted layer of not less than 2 feet of suitable material over the entire surface of each portion of the final lift not later than 60 days following placement of refuse in the final lift, in violation of Rule 305(c) and Section 21(a) and (b) of the Act on the following dates:

1. September 2, 1977
  - a. See inspection report, page 3.
2. September 8, 1977
  - a. See inspection report, page 6.
3. September 29, 1977
  - a. See inspection report, page 11.

4. October 6, 1977
  - a. See inspection report, page 15.
5. March 8, 1978
  - a. See inspection report, page 18.
6. March 9, 1978
  - a. See inspection report, page 25.
7. March 10, 1978
  - a. See inspection report, page 36.

G. Failure to take adequate measures to control vectors, in violation of Rule 314(f) on the following dates:

1. March 9, 1978
  - a. See inspection report for evidence of bird feeding (page 25).
2. March 10, 1978
  - a. See inspection report for evidence of bird feeding (page 36).

H. Causing or allowing open burning at a sanitary landfill, in violation of Rule 311 on the following dates:

1. March 9, 1978
  - a. Evidence of underground fire, page 25.
2. March 10, 1978
  - a. Evidence of underground fire, page 36.
  - b. One (1) photograph showing smoke rising from fissure, page 35.

I. Causing or allowing operation of a sanitary landfill so as to cause or threaten or allow the discharge of any contaminant into the environment in any state so as to cause or tend to cause water pollution in Illinois, in violation of Rule 313 on the following dates:

1. September 8, 1977
  - a. See inspection report, page 6.
2. March 9, 1978
  - a. Garbage in standing water, see page 25.
  - b. Two (2) photographs, pages 27-28.
3. March 10, 1978
  - a. Garbage in standing water, see page 36.

Page 5

Based upon the above-cited allegations, the Agency requests that your office file the appropriate action in the Circuit Court of Peoria County to enforce the Board Order. The Agency would further request that an immediate closure order be sought against the Respondent.

The following Agency personnel may be called to testify in this case:

John Taylor  
Tom Scotese  
Terry Ayers

The appropriate witness qualification forms may be found at pages 44-49.

As always, please provide me with twenty-four (24) hours notice prior to filing the Complaint. In addition, please provide me with a copy of the Complaint as filed, including the docket number assigned.

Sincerely,

Delbert D. Haschemeyer  
Manager Enforcement Programs

DDH:TRC:cn/3428/spi-5